


Key Plan



North

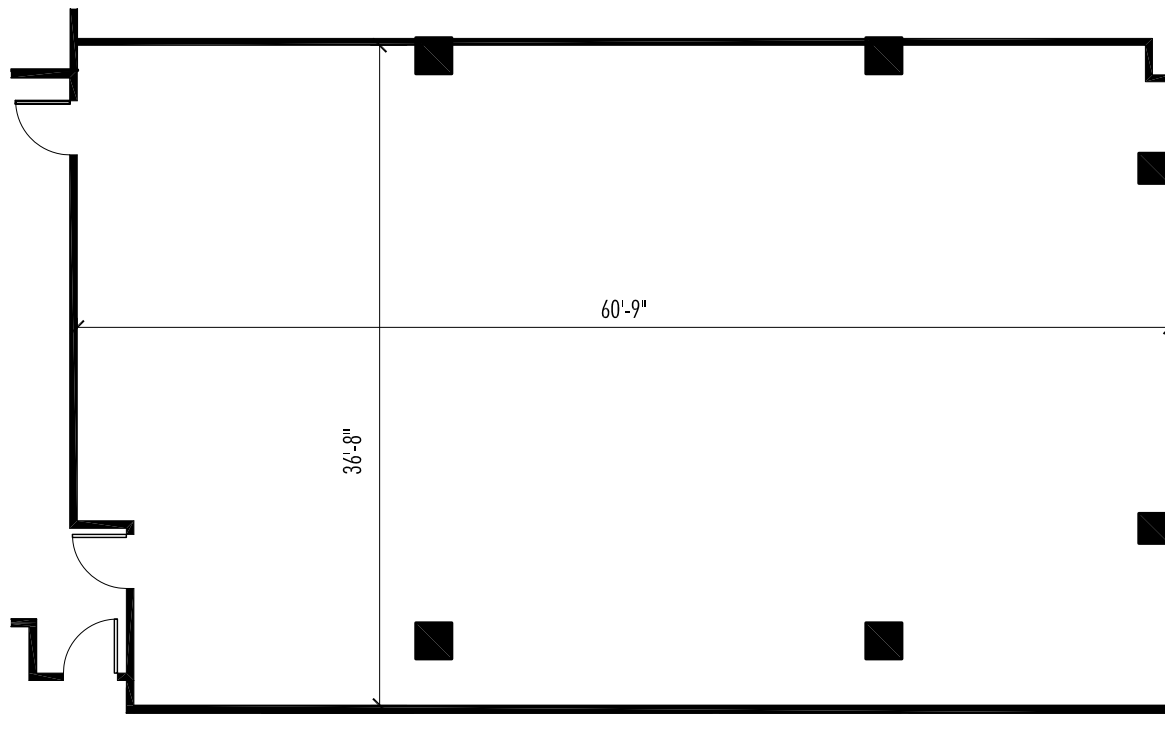

Sabrina Gibson 404.504.7885

Clark Gore 404.923.1213

Eric Ross 404.229.7629



Windward Fairways II • Suite 420 • 2,603 RSF

As Built