


Key Plan



Sabrina Gibson 404.504.7885
Clark Gore 404.923.1213
Eric Ross 404.229.7629

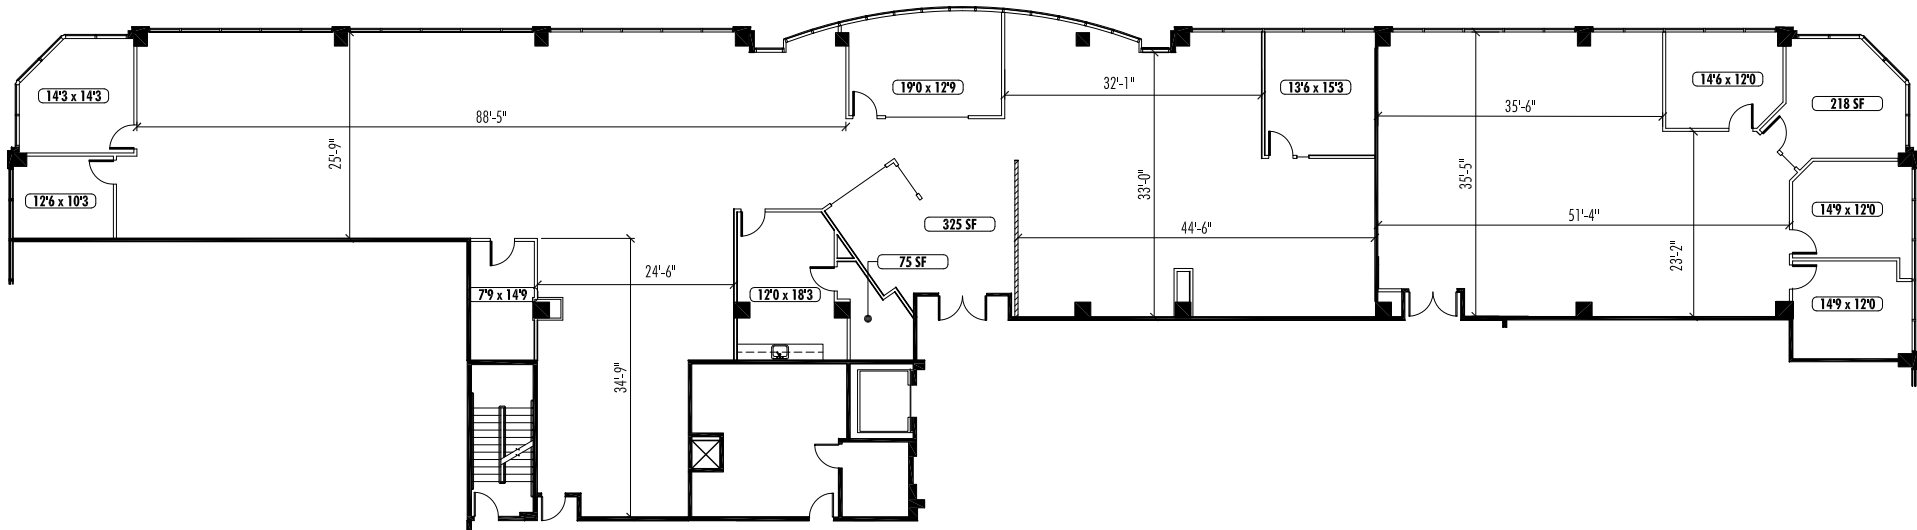

Windward Fairways II • Suites 505 & 525 • 10,560 RSF

As Built