



Key Plan

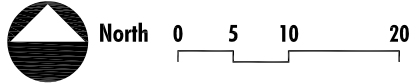

Sabrina Gibson 404.504.7885
Clark Gore 404.923.1213
Eric Ross 404.229.7629

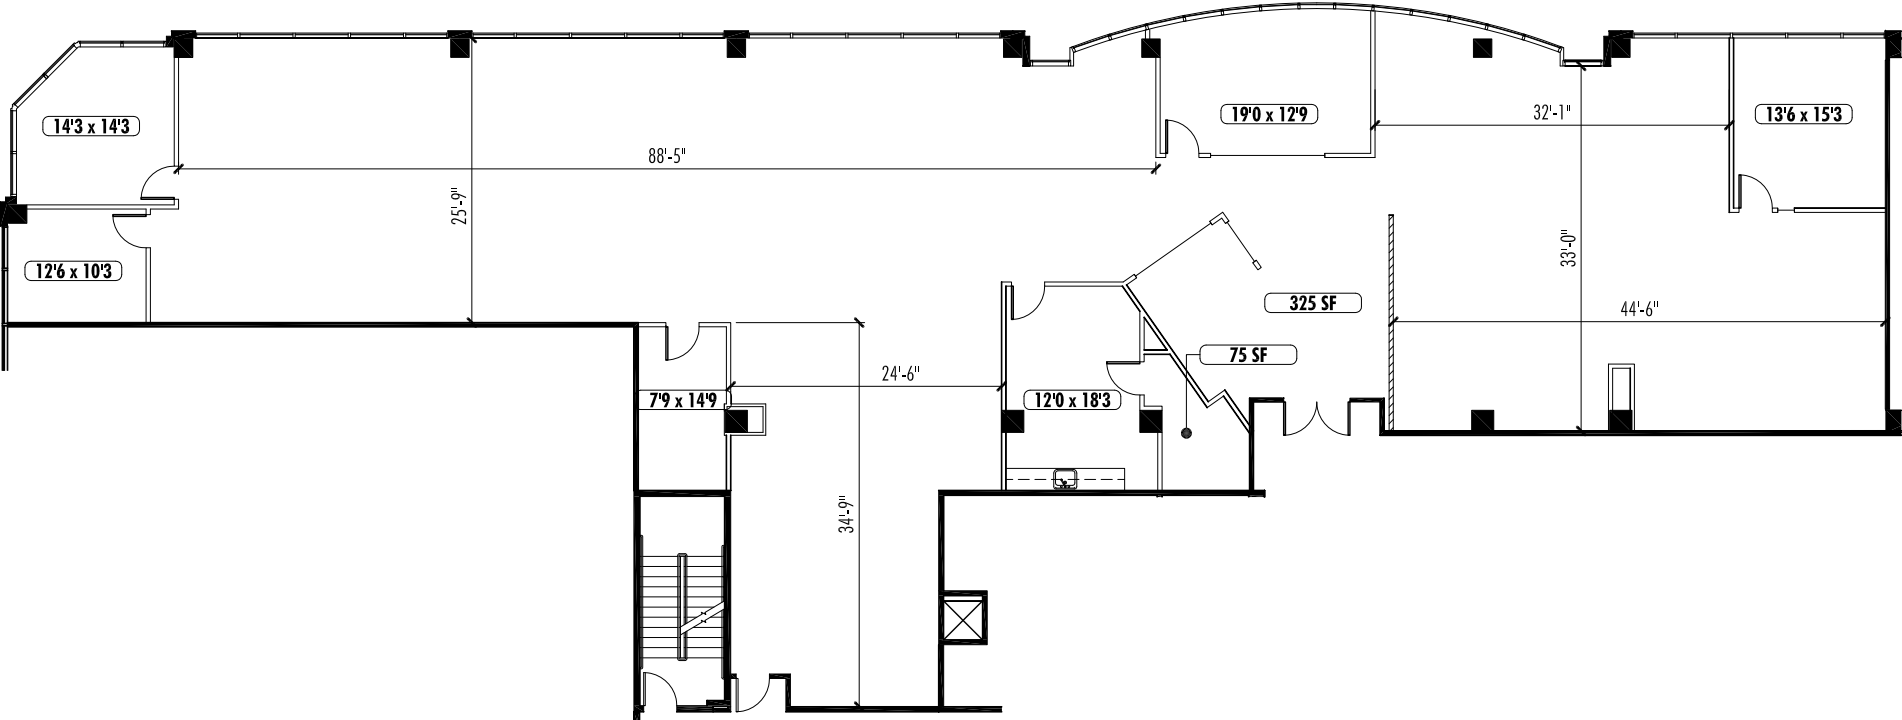

Windward Fairways II • Suite 505 • 7,312 RSF

As Built